



175 BREWSTER STREET

SAN FRANCISCO


Floor Plans - As Built

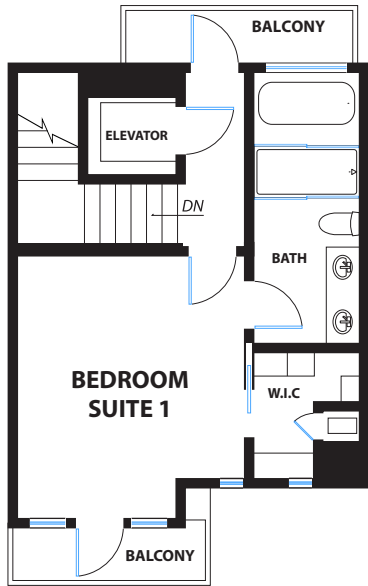


LEVEL FOUR - TOP FLOOR

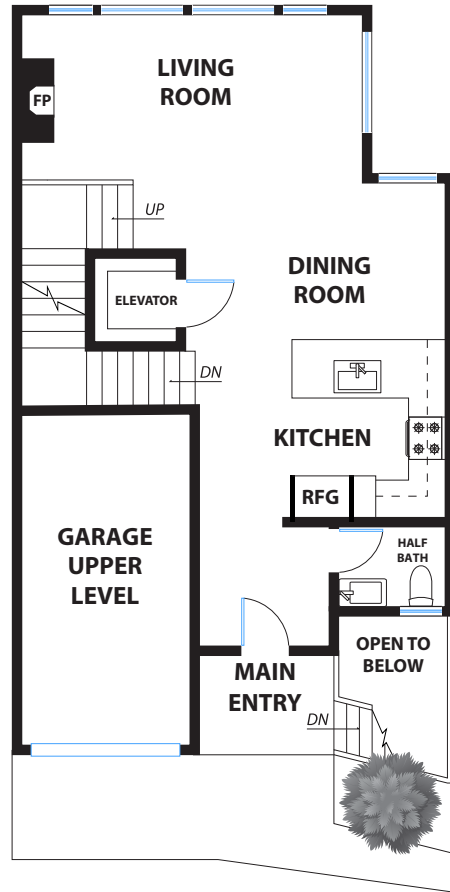

LEVEL THREE - MAIN ENTRY

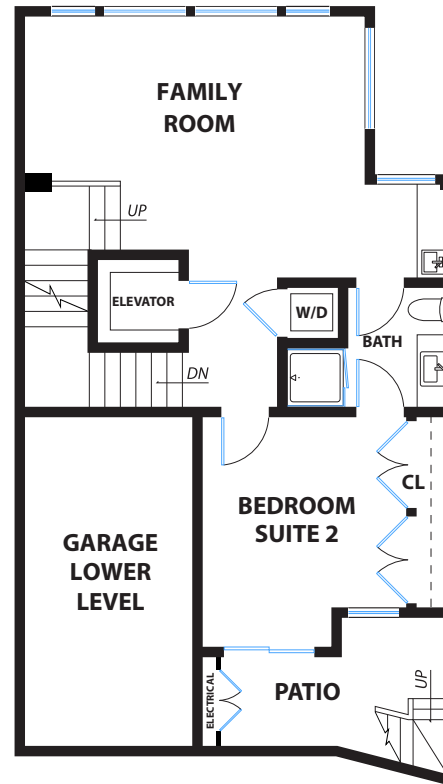

LEVEL TWO

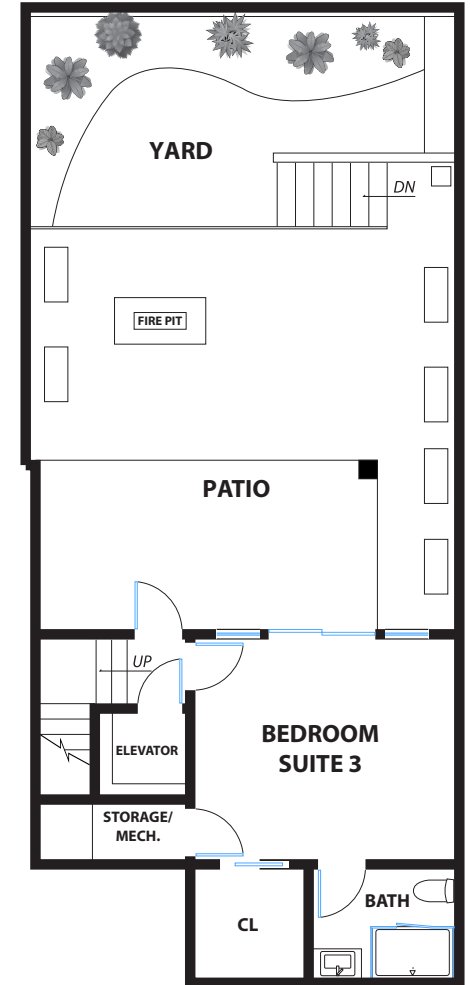

LEVEL ONE - BOTTOM FLOOR